


Total Occupant Area 15,989.20

Floor Service Area	0
Building Service Area	0
Total Vertical	0

Suite #	Occupant Area
Dry Storage	6,012.99
Cooler 6	9,976.21
Total Warehouse Area	15,989.20

Neighboring Property

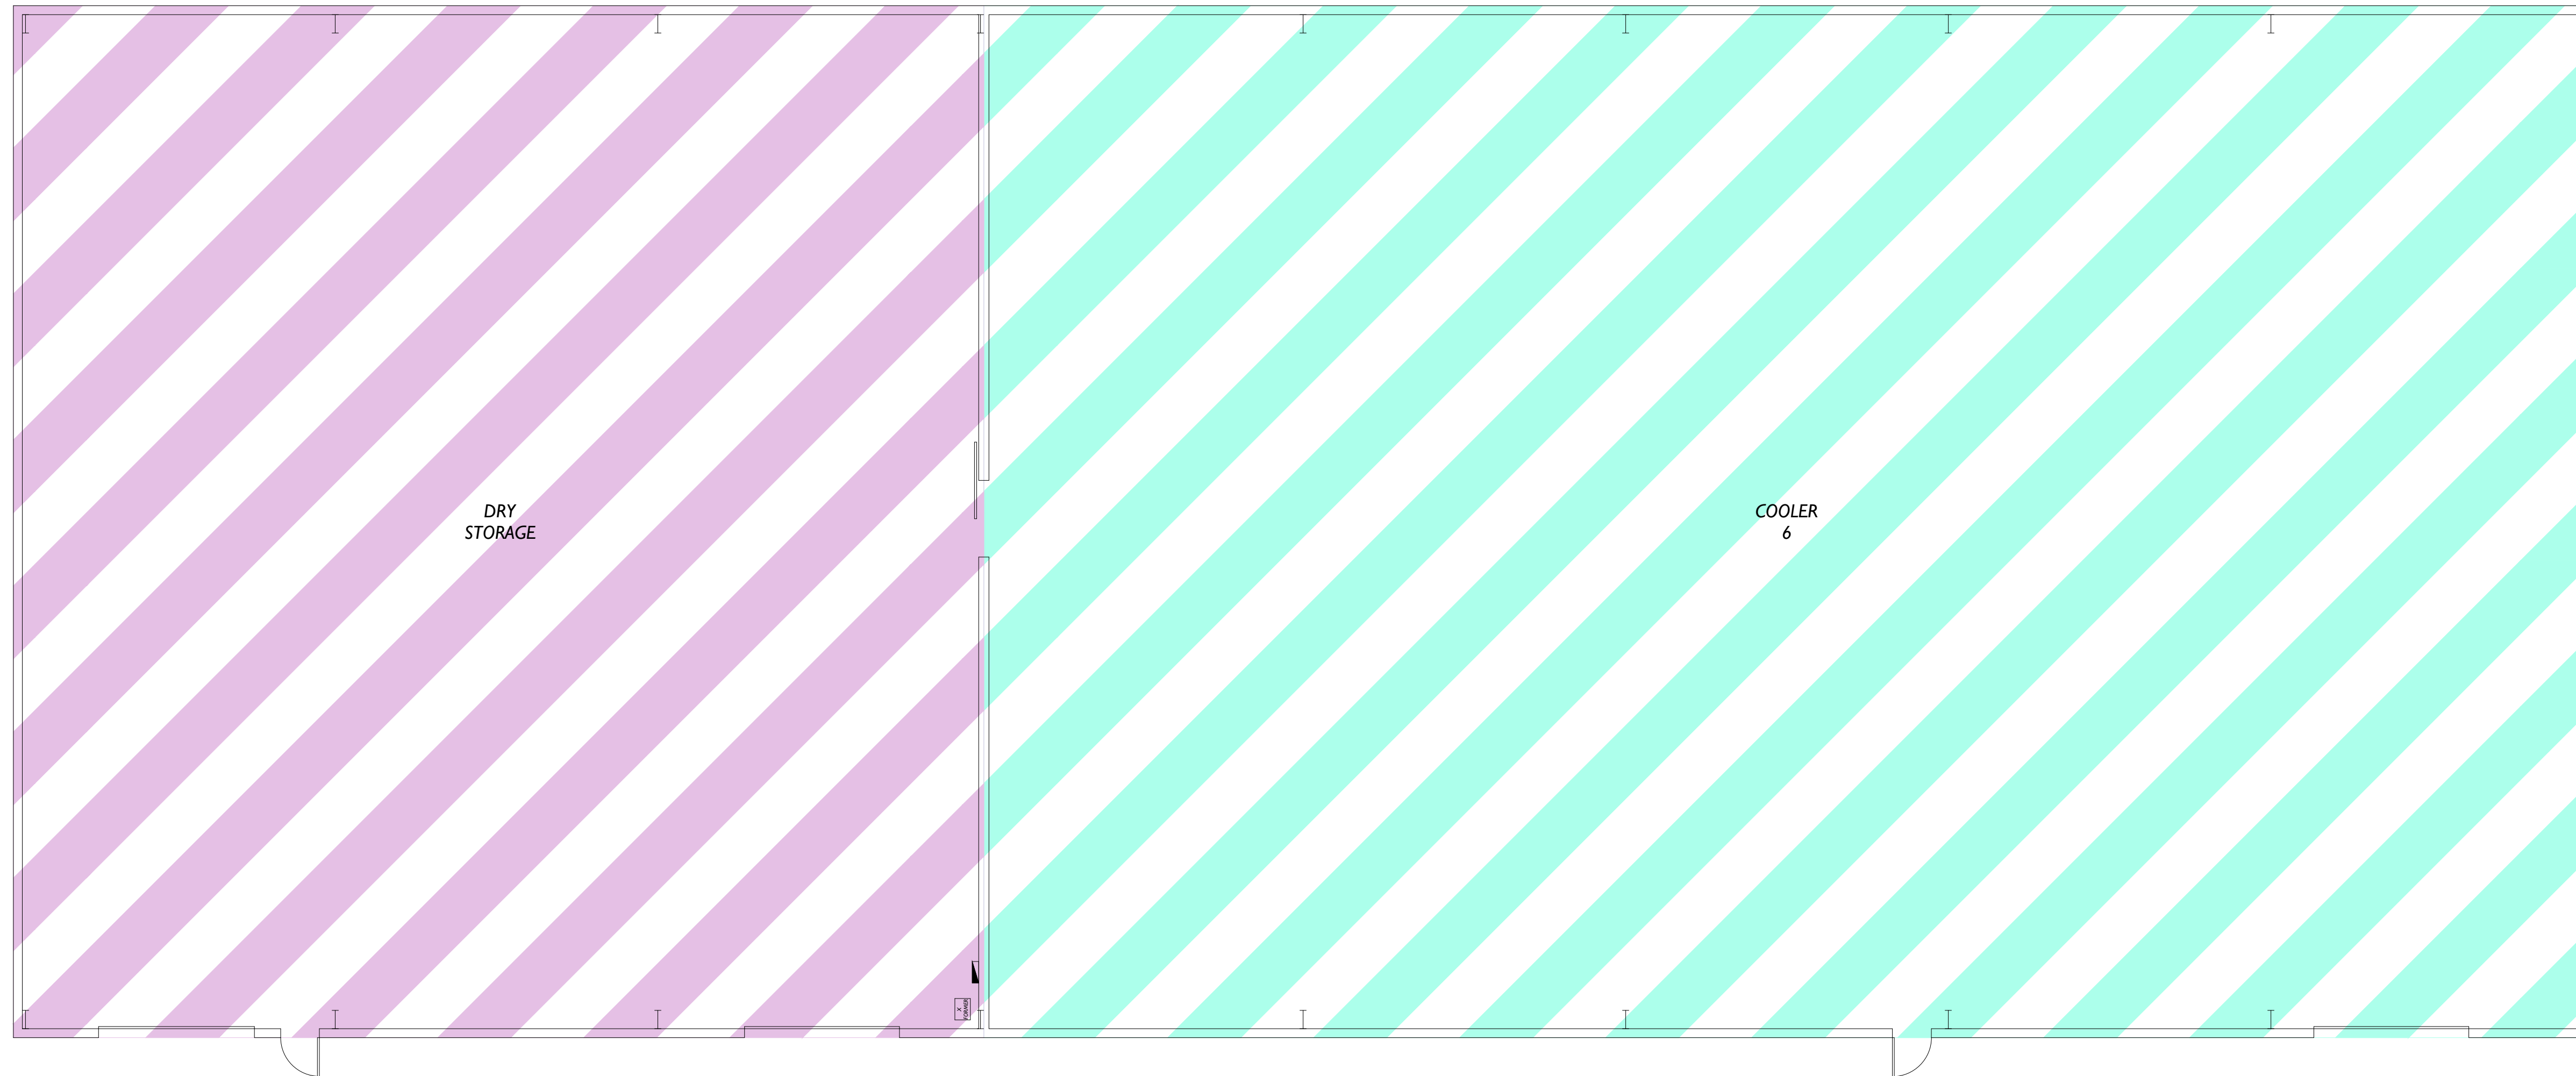

2-D AS-BUILT FLOOR PLANS

2DFLOORPLANS.COM

**371 NW Gilman Blvd.
Suite 140
Issaquah, WA 98027
425-677-7511**

This drawing is an instrument of service and is the sole property of the client listed. Any alteration of this drawing without removal of references to 2-D As-Built Floor Plans, Inc. is prohibited.

Drawing scale and dimensions are provided for reference only. Refer to CAD files for exact measurements.

©2010 2-D As-Built Floor Plans, Inc.
All Rights Reserved.

**Area Analysis performed
in accordance with
ANSI/BOMA Z65.2 - 2019.**

Project: C23-625


[illegible]

Client:

Leavitt Capital Companies, LLC
12709 E Mirabeau Pkwy, Ste 10
Spokane Valley, WA 99216

ite:

Industrial Park
25491 NE State Route 3
Belfair, WA 98528

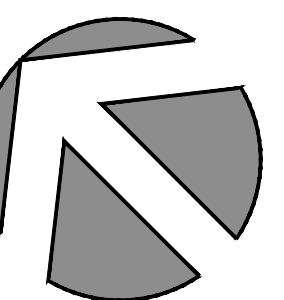

Lease Plan


C6

Building

Log Yard Road

State Route 3

Access Drive

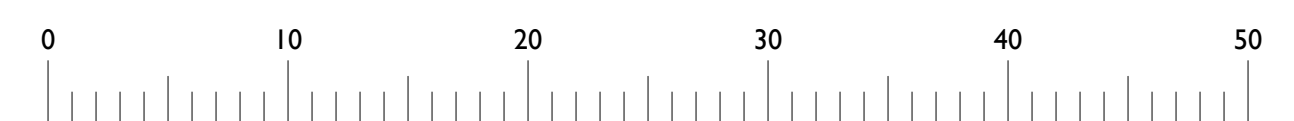

Scale: 1/8" = 1'-0"